



D AS-BUILT

1:50

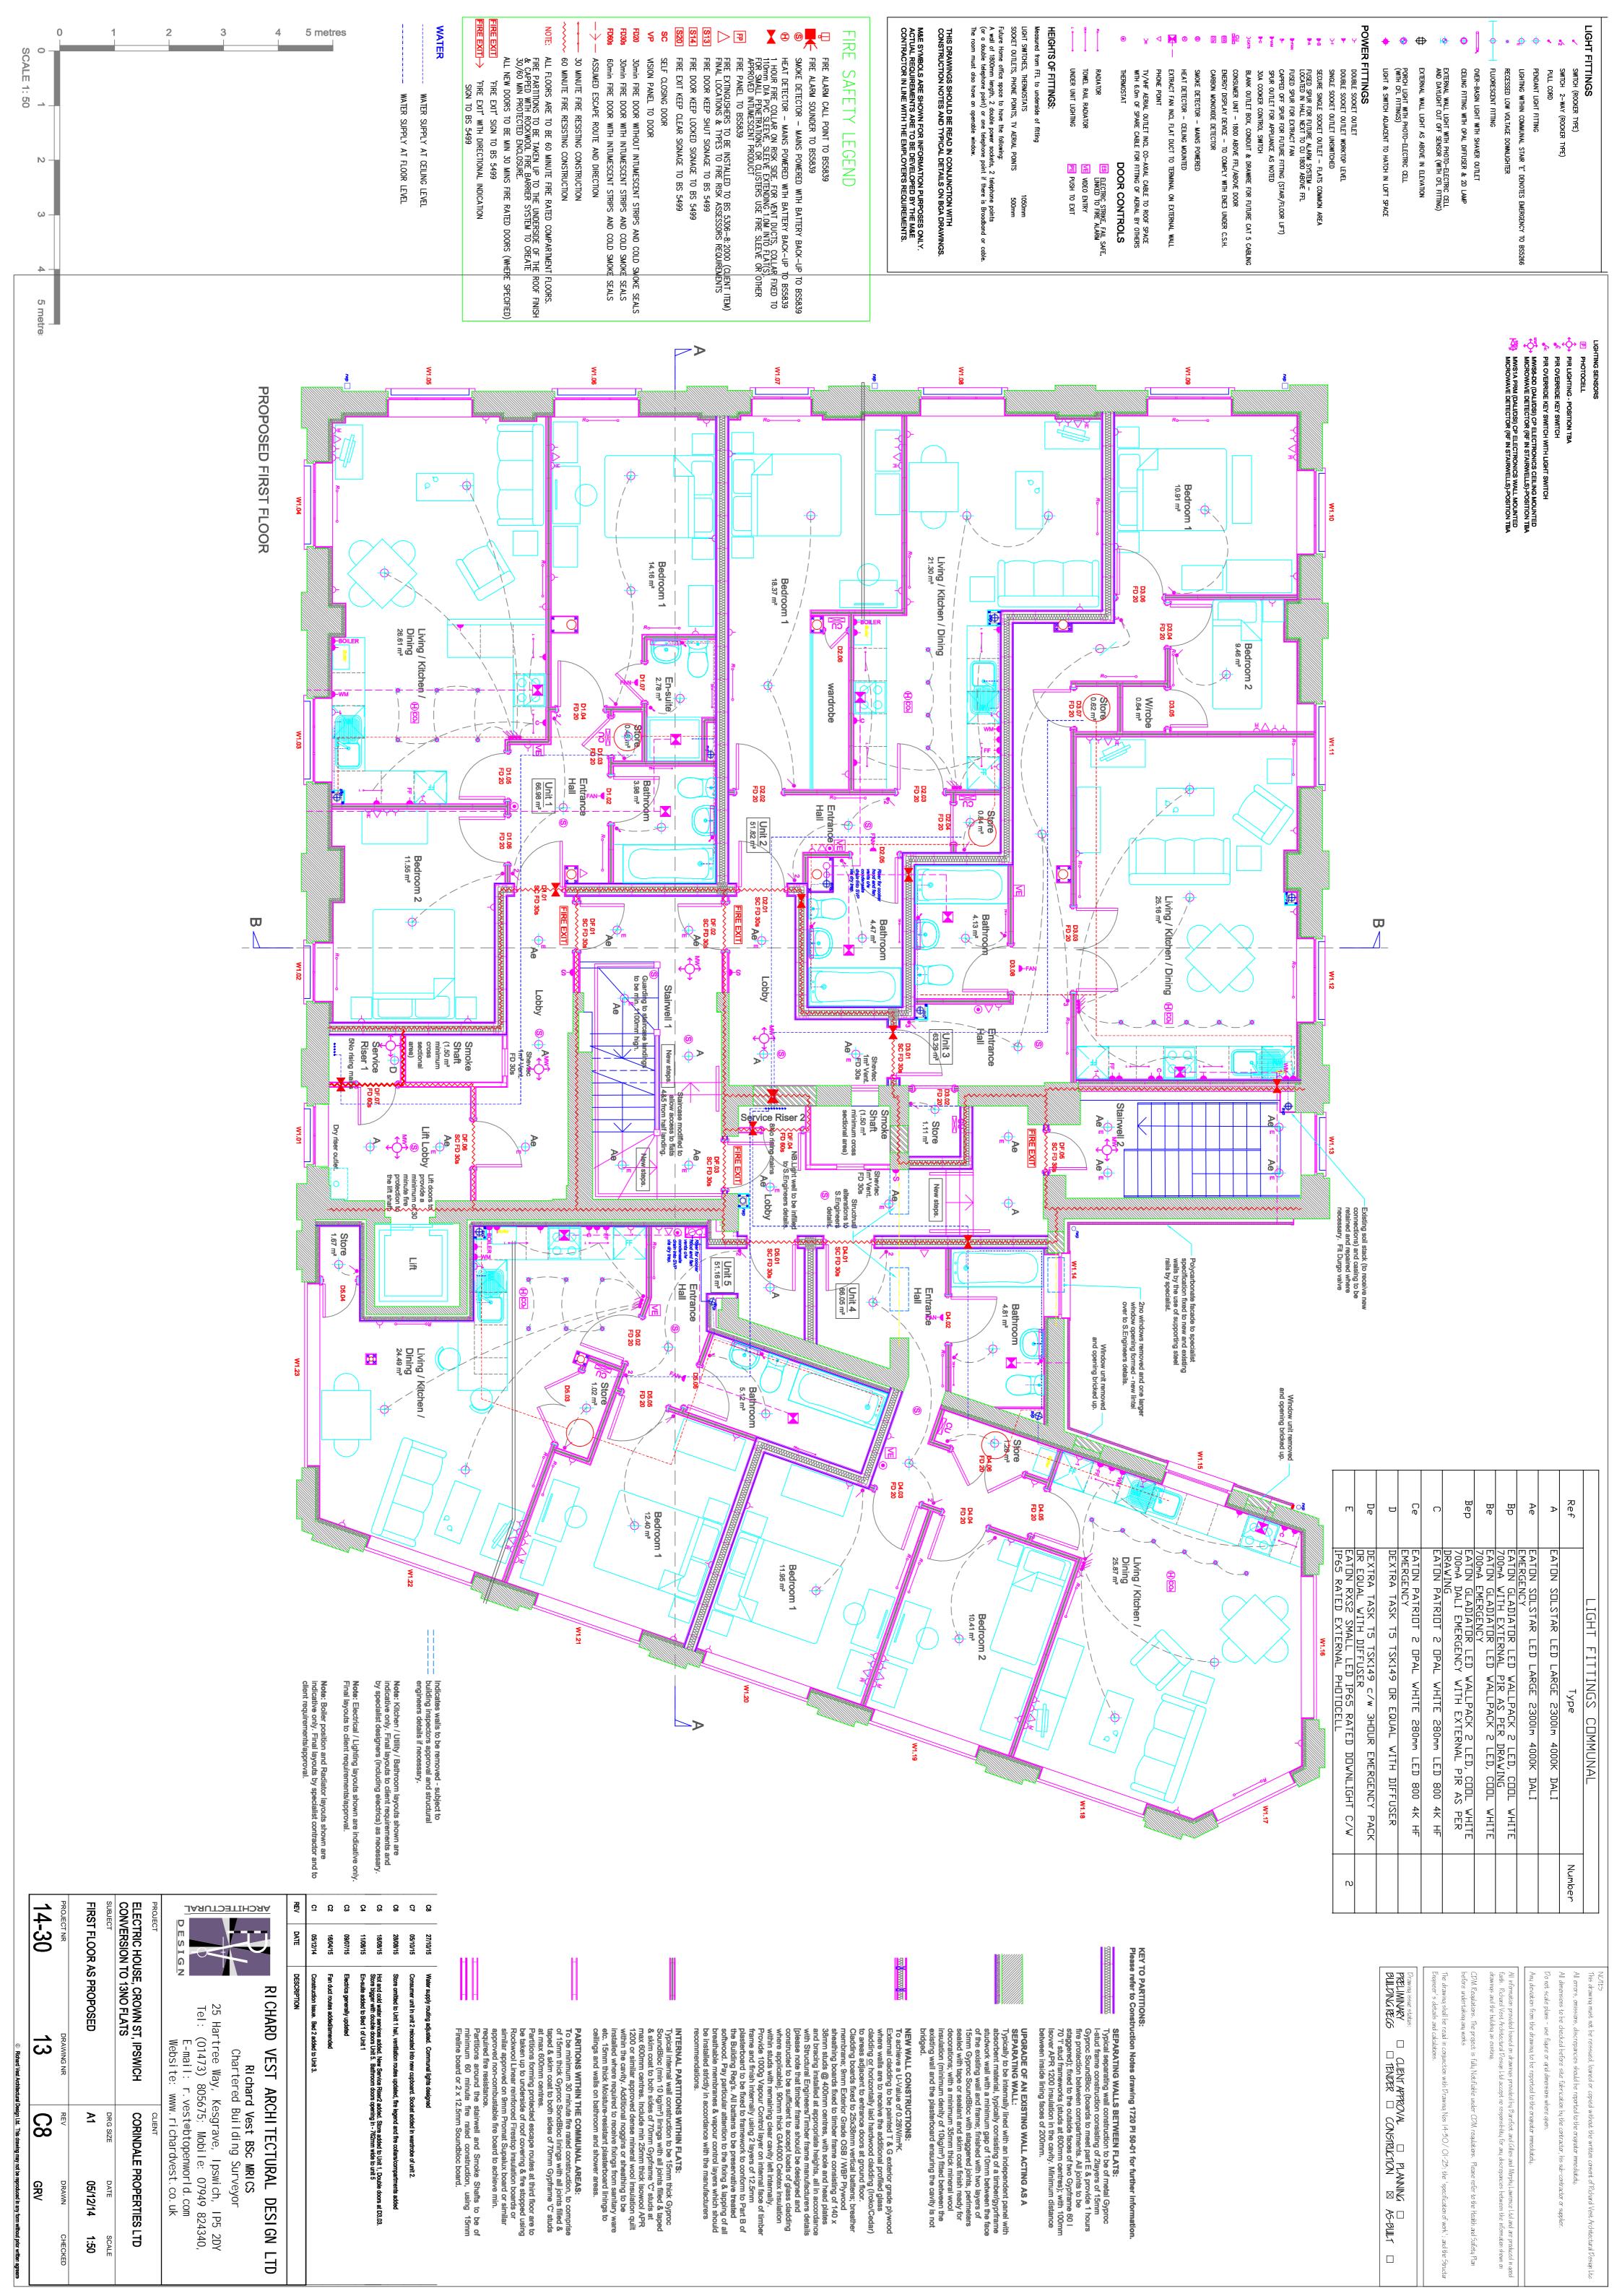

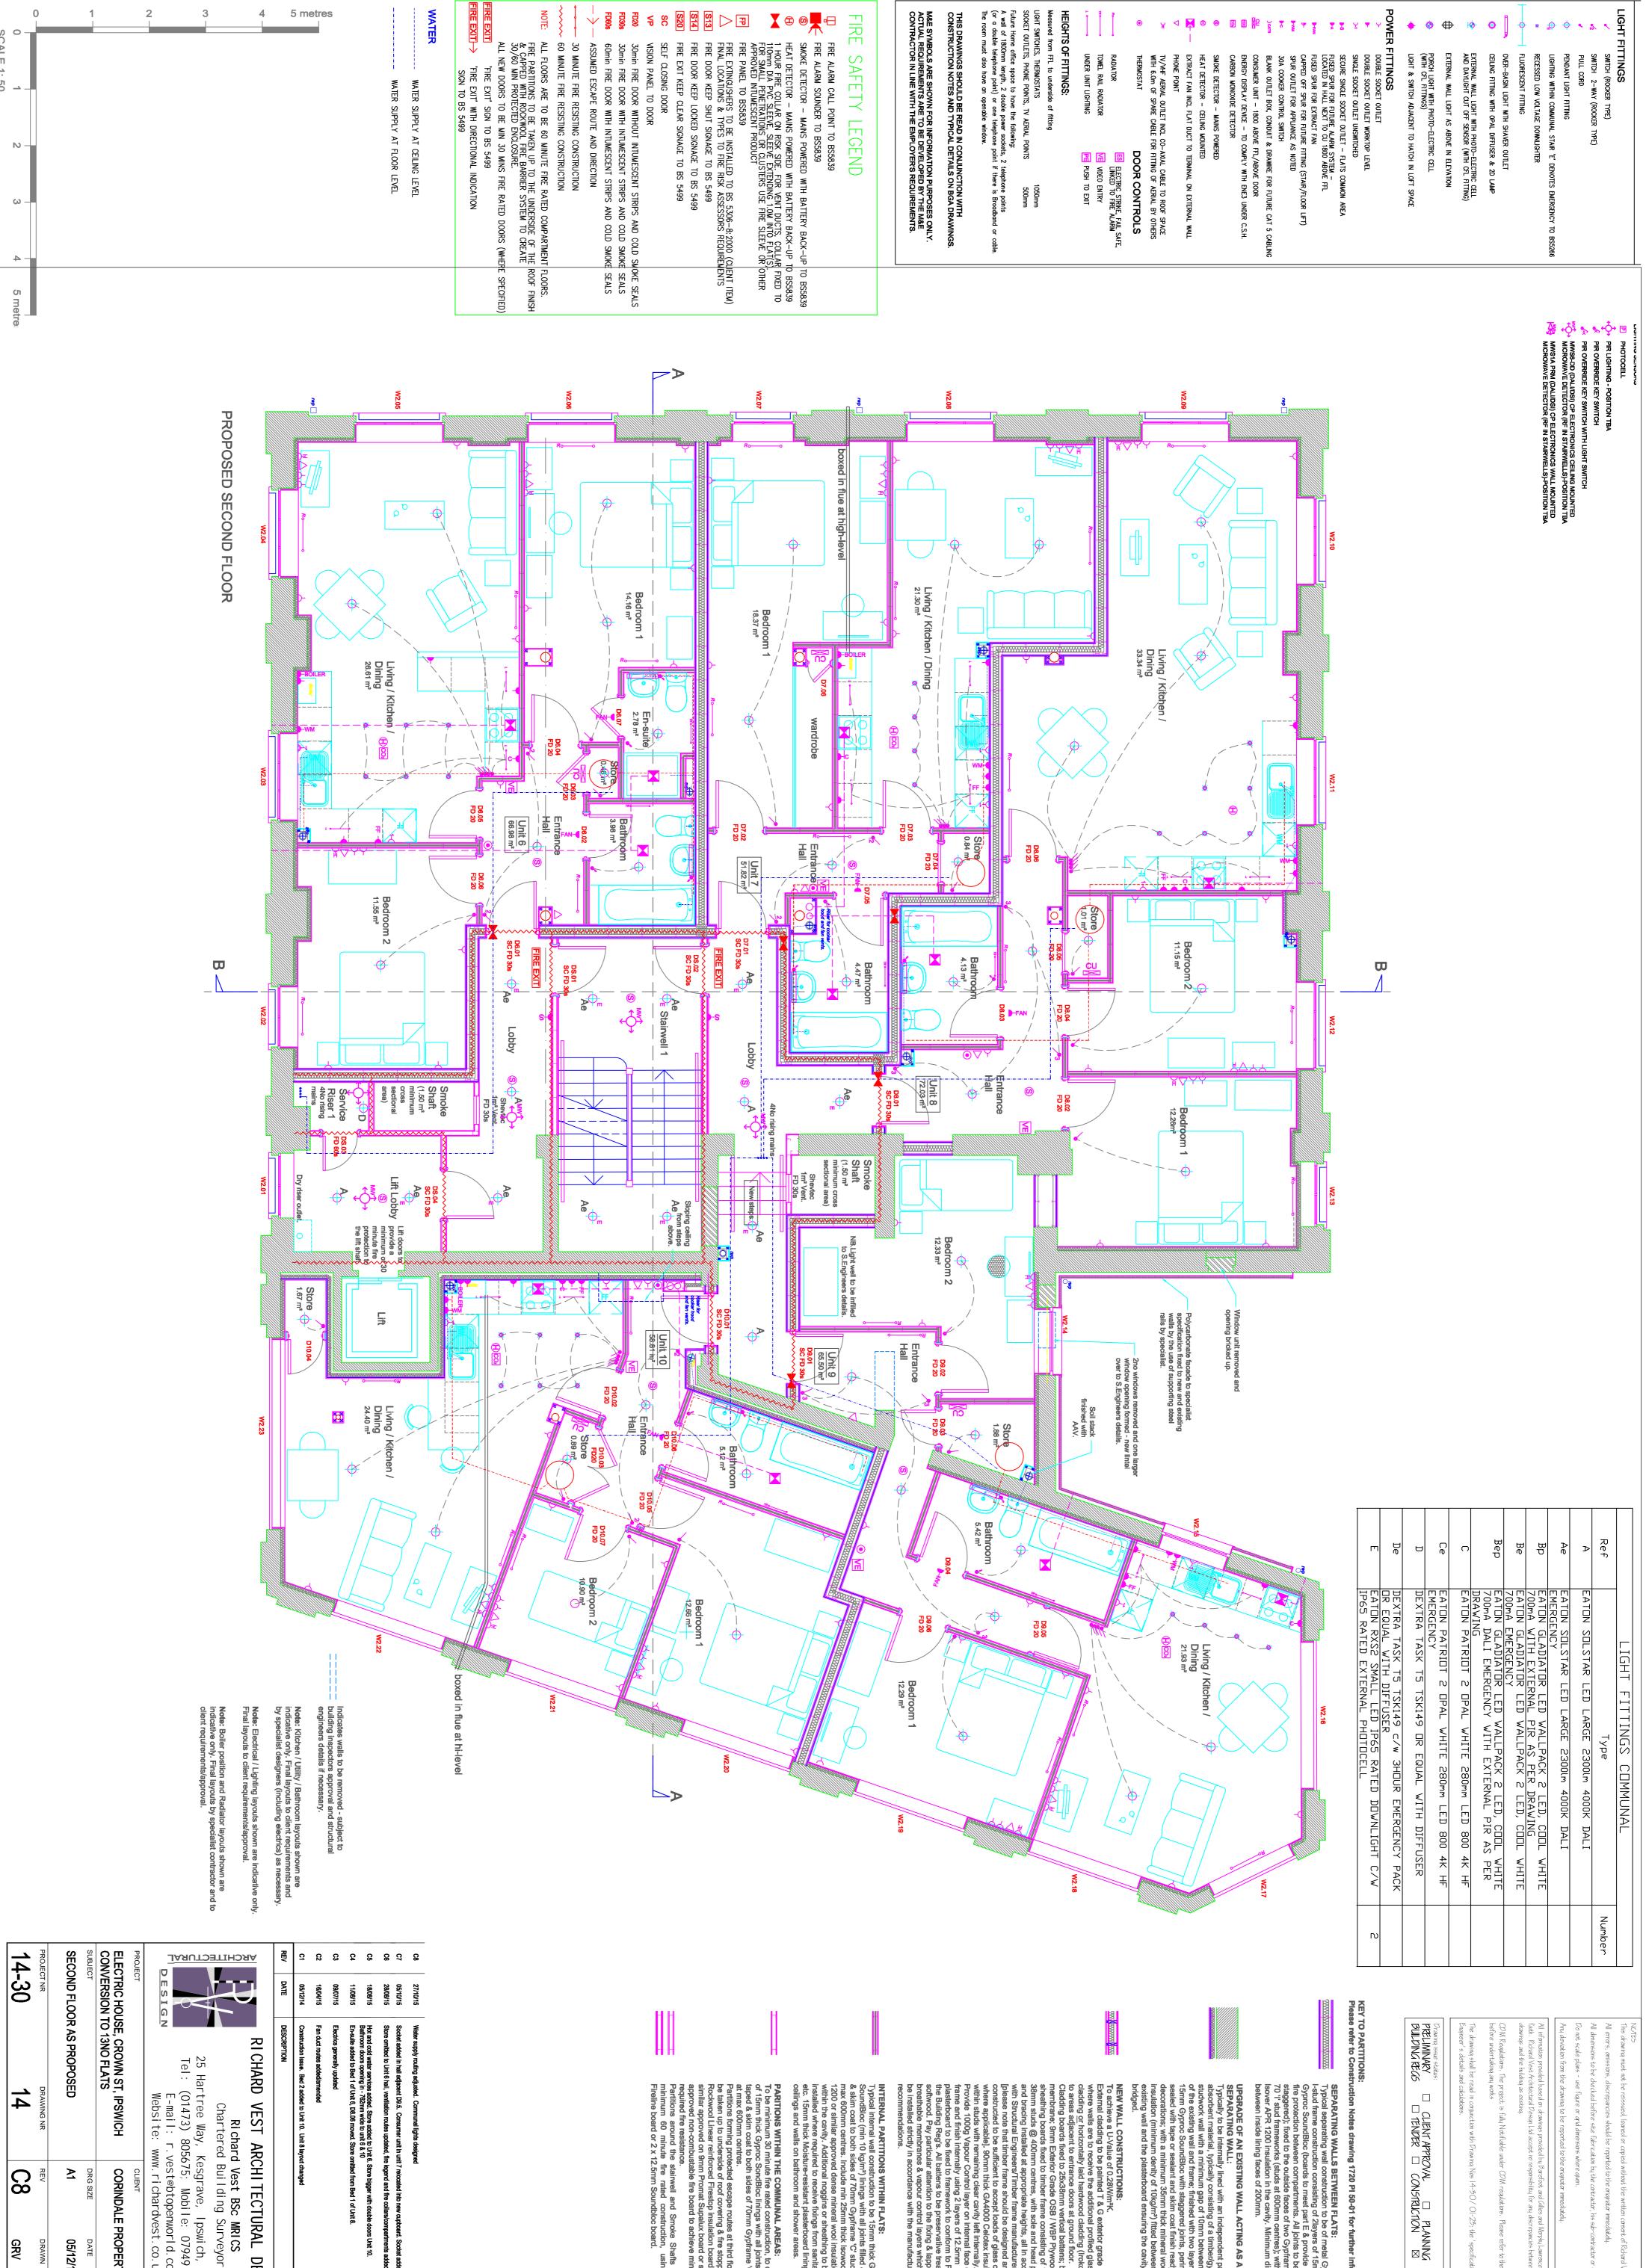

14-30/01-23; the

☐ CLIENT APPROVAL ☐ PLANNING ☐ TENDER ☐ CONSTRUCTION ☒ O AS-BUILT

SEPARATING WALLS BETWEEN FLATS:

Typical separating wall construction to be of metal Gyproc I-stud frame construction consisting of 2layers of 15mm Gyproc SoundBloc (boards to meet part E & provide 1 hours fire protection between compartments. All joints to be staggered); fixed to the outside faces of two Gypframe 60 I 70 'I' stud frameworks (studs at 600mm centres); with 100mm Isover APR 1200 insulation in the cavity. Minimum distance between inside lining faces of 200mm.

JPGRADE OF AN EXISTING WALL ACTING AS A SEPARATING WALL:

'ypically to be internally lined with an independent panel with ibsorbent material, typically consisting of a timber/gypriframe studwork wall with a minimum gap of 10mm between the face of the existing wall and frame; finished with two layers of 5mm Gyproc SoundBloc with staggered joints, perimeters sealed with tape or sealant and skim coat finish ready for lecorations; with a minimum 35mm thick mineral wool issulation (minimum denity of 10kg/m³) fitted between the xisting wall and the plasterboard ensuring the cavity is not ridged.

item wall constructions:

Acternal cladding to be painted T & G exterior grade plywood where walls are to receive the additional profiled glass sladding or horizontally laid hardwood cladding (Iroko/Cedar) o areas adjacent to entrance doors at ground floor.

Jadding boards fixed to 25x38mm vertical battens; breather nembrane; 9mm Exterior Grade OSB / WBP Plywood heathing boards fixed to timber frame consisting of 140 x 38mm studs @ 400mm centres, with sole and head plates and bracing installed at appropriate heights, all in accordance with Structural Engineers/Timber frame manufacturers details please note that timber frame should be designed and constructed to be sufficient to accept loads of glass cladding where applicable]. 90mm thick GA4000 Celotex insulation within studs with remaining clear cavity left internally.

Provide 1000g Vapour Control layer on internal face of timber frame and finish internally using 2 layers of 12.5mm plasterboard to be fixed to framework to conform to Part B of the Building Reg's. All battens to be preservative treated softwood. Pay particular attention to the fixing & lapping of all preathable membranes & vapour control layers which should be installed strictly in accordance with the manufacturers recommendations.

HEIGHTS OF FITTINGS:
Measured from FFL to underside

POWER FITTINGS

DOUBLE SOCK

INTERNAL PARTITIONS WITHIN FLATS:
Typical internal wall construction to be 15mm thick Gyproc SoundBloc (min 10 kg/m²) linings with all joints filled & taped & skim coat to both sides of 70mm Gypframe 'C' studs at max 600mm centres. Include min 25mm thick Isowool APR 1200 or similar approved dense mineral wool insulation quilt within the cavity. Additional noggins or sheathing to be installed where required to receive fixings from sanitary ware etc. 15mm thick Moisture-resistant plasterboard linings to ceilings and walls on bathroom and shower areas.

PARITIONS WITHIN THE COMMUNAL AREAS:

To be minimum 30 minute fire rated construction, to comprise of 15mm thick Gyproc SondBloc linings with all joints filled & taped & skim coat to both sides of 70mm Gypframe 'C' studs at max 600mm centres.

Partitions forming protected escape routes at third floor are to be taken up to underside of roof covering & fire stopped using Rockwool Linear reinforced Firestop insulation boards or similar approved on 9mm Promat Supalux board or similar approved non-combustable fire board to achieve min. required fire resistance.

Partitions around the stairwell and Smoke Shafts to be of minimum 60 minute fire rated construction, using 15mm Fireline board or 2 x 12.5mm Soundbloc board.

WATER

RE EXIT

FIRE

5 metres

0 1 SCALE 1: 50

RICHARD VEST ARCHITECTURAL DESIGN LTD

25 Hartree Way, Kesgrave, Ipswich, IP5 2DY Tel: (01473) 805675; Mobile: 07949 824340, E-mail: r.vest@btopenworld.com Website: www.richardvest.co.uk

CORINDALE PROPERTIES LTD 05/12/14 1:50



☐ CLIENT APPROVAL ☐ PLANNING ☐ TENDER ☐ CONSTRUCTION ☒ D AS-BUILT

SEPARATING WALLS BETWEEN FLATS:

Typical separating wall construction to be of metal Gyproc I-stud frame construction consisting of 2layers of 15mm Gyproc SoundBloc (boards to meet part E & provide 1 hours fire protection between compartments. All joints to be staggered); fixed to the outside faces of two Gypframe 60 I 70 "I stud frameworks (studs at 600mm centres); with 100mm Isover APR 1200 insulation in the cavity. Minimum distance between inside lining faces of 200mm.

UPGRADE OF AN EXISTING WALL ACTING AS A SEPARATING WALL:

Typically to be internally lined with an independent panel with absorbent material, typically consisting of a timber/gyprframe studwork wall with a minimum gap of 10mm between the face of the existing wall and frame; finished with two layers of 15mm Gyproc SoundBloc with staggered joints, perimeters sealed with tape or sealant and skim coat finish ready for decorations; with a minimum 35mm thick mineral wool insulation (minimum denity of 10kg/m³) fitted between the existing wall and the plasterboard ensuring the cavity is not bridged.

NEW WALL CONSTRUCTIONS:

To achieve a U-Value of 0.28W/m²K.

External cladding to be painted T & G exterior grade plywood where walls are to receive the additional profiled glass cladding or horizontally laid hardwood cladding (Iroko/Cedar) to areas adjacent to entrance doors at ground floor.

Cladding boards fixed to 25x38mm vertical battens; breather membrane; 9mm Exterior Grade OSB / WBP Plywood sheathing boards fixed to timber frame consisting of 140 x 38mm studs @ 400mm centres, with sole and head plates and bracing installed at appropriate heights, all in accordance with Structural Engineers/Timber frame manufacturers details [please note that timber frame should be designed and constructed to be sufficient to accept loads of glass cladding where applicable]. 90mm thick GA4000 Celotex insulation within studs with remaining clear cavity left internally.

Provide 1000g Vapour Control layer on internal face of timber frame and finish internally using 2 layers of 12.5mm plasterboard to be fixed to framework to conform to Part B of the Building Reg's. All battens to be preservative treated softwood. Pay particular attention to the fixing & lapping of all breathable membranes & vapour control layers which should be installed strictly in accordance with the manufacturers recommendations.

INTERNAL PARTITIONS WITHIN FLATS:

Typical internal wall construction to be 15mm thick Gyproc SoundBloc (min 10 kg/m²) linings with all joints filled & taped & skim coat to both sides of 70mm Gypframe 'C' studs at max 600mm centres. Include min 25mm thick Isowool APR 1200 or similar approved dense mineral wool insulation quilt within the cavity. Additional noggins or sheathing to be installed where required to receive fixings from sanitary ware etc. 15mm thick Moisture-resistant plasterboard linings to ceilings and walls on bathroom and shower areas.

RICHARD VEST ARCHITECTURAL DESIGN LTD

Richard Vest BSc MRICS Chartered Building Surveyor

25 Hartree Way, Kesgrave, Ipswich, IP5 2DY Tel: (01473) 805675; Mobile: 07949 824340, E-mail: r.vest@btopenworld.com Website: www.richardvest.co.uk

CORINDALE PROPERTIES LTD 05/12/14 GRV 1:50