




D	GLASS SCREEN REMOVED	30/07/12	HK
C	COLOURS & FW AREA UPDATED TO AS BUILT	19/04/11	OQ
B	FOOTWEAR COLOURS UPGRADED	29/03/11	FT
A	FOOTWEAR UPGRADED	24/03/11	FT
REVISIONS	DESCRIPTION	DATE	INITIAL
RIVER ISLAND			
T: 020 8991 4500 F: 020 8998 1171 E: cad@river-island.com Chelsea House - West Gate - London - W5 1DR			
PROJECT	WOLVERHAMPTON 25/26 DUDLEY STREET	DATE	08/04/08
TITLE	FIRST FLOOR LAYOUT	SCALE	1:50 @ A1
		DRAWN BY	JC
		DRAWING NO.	030/ML0803 D

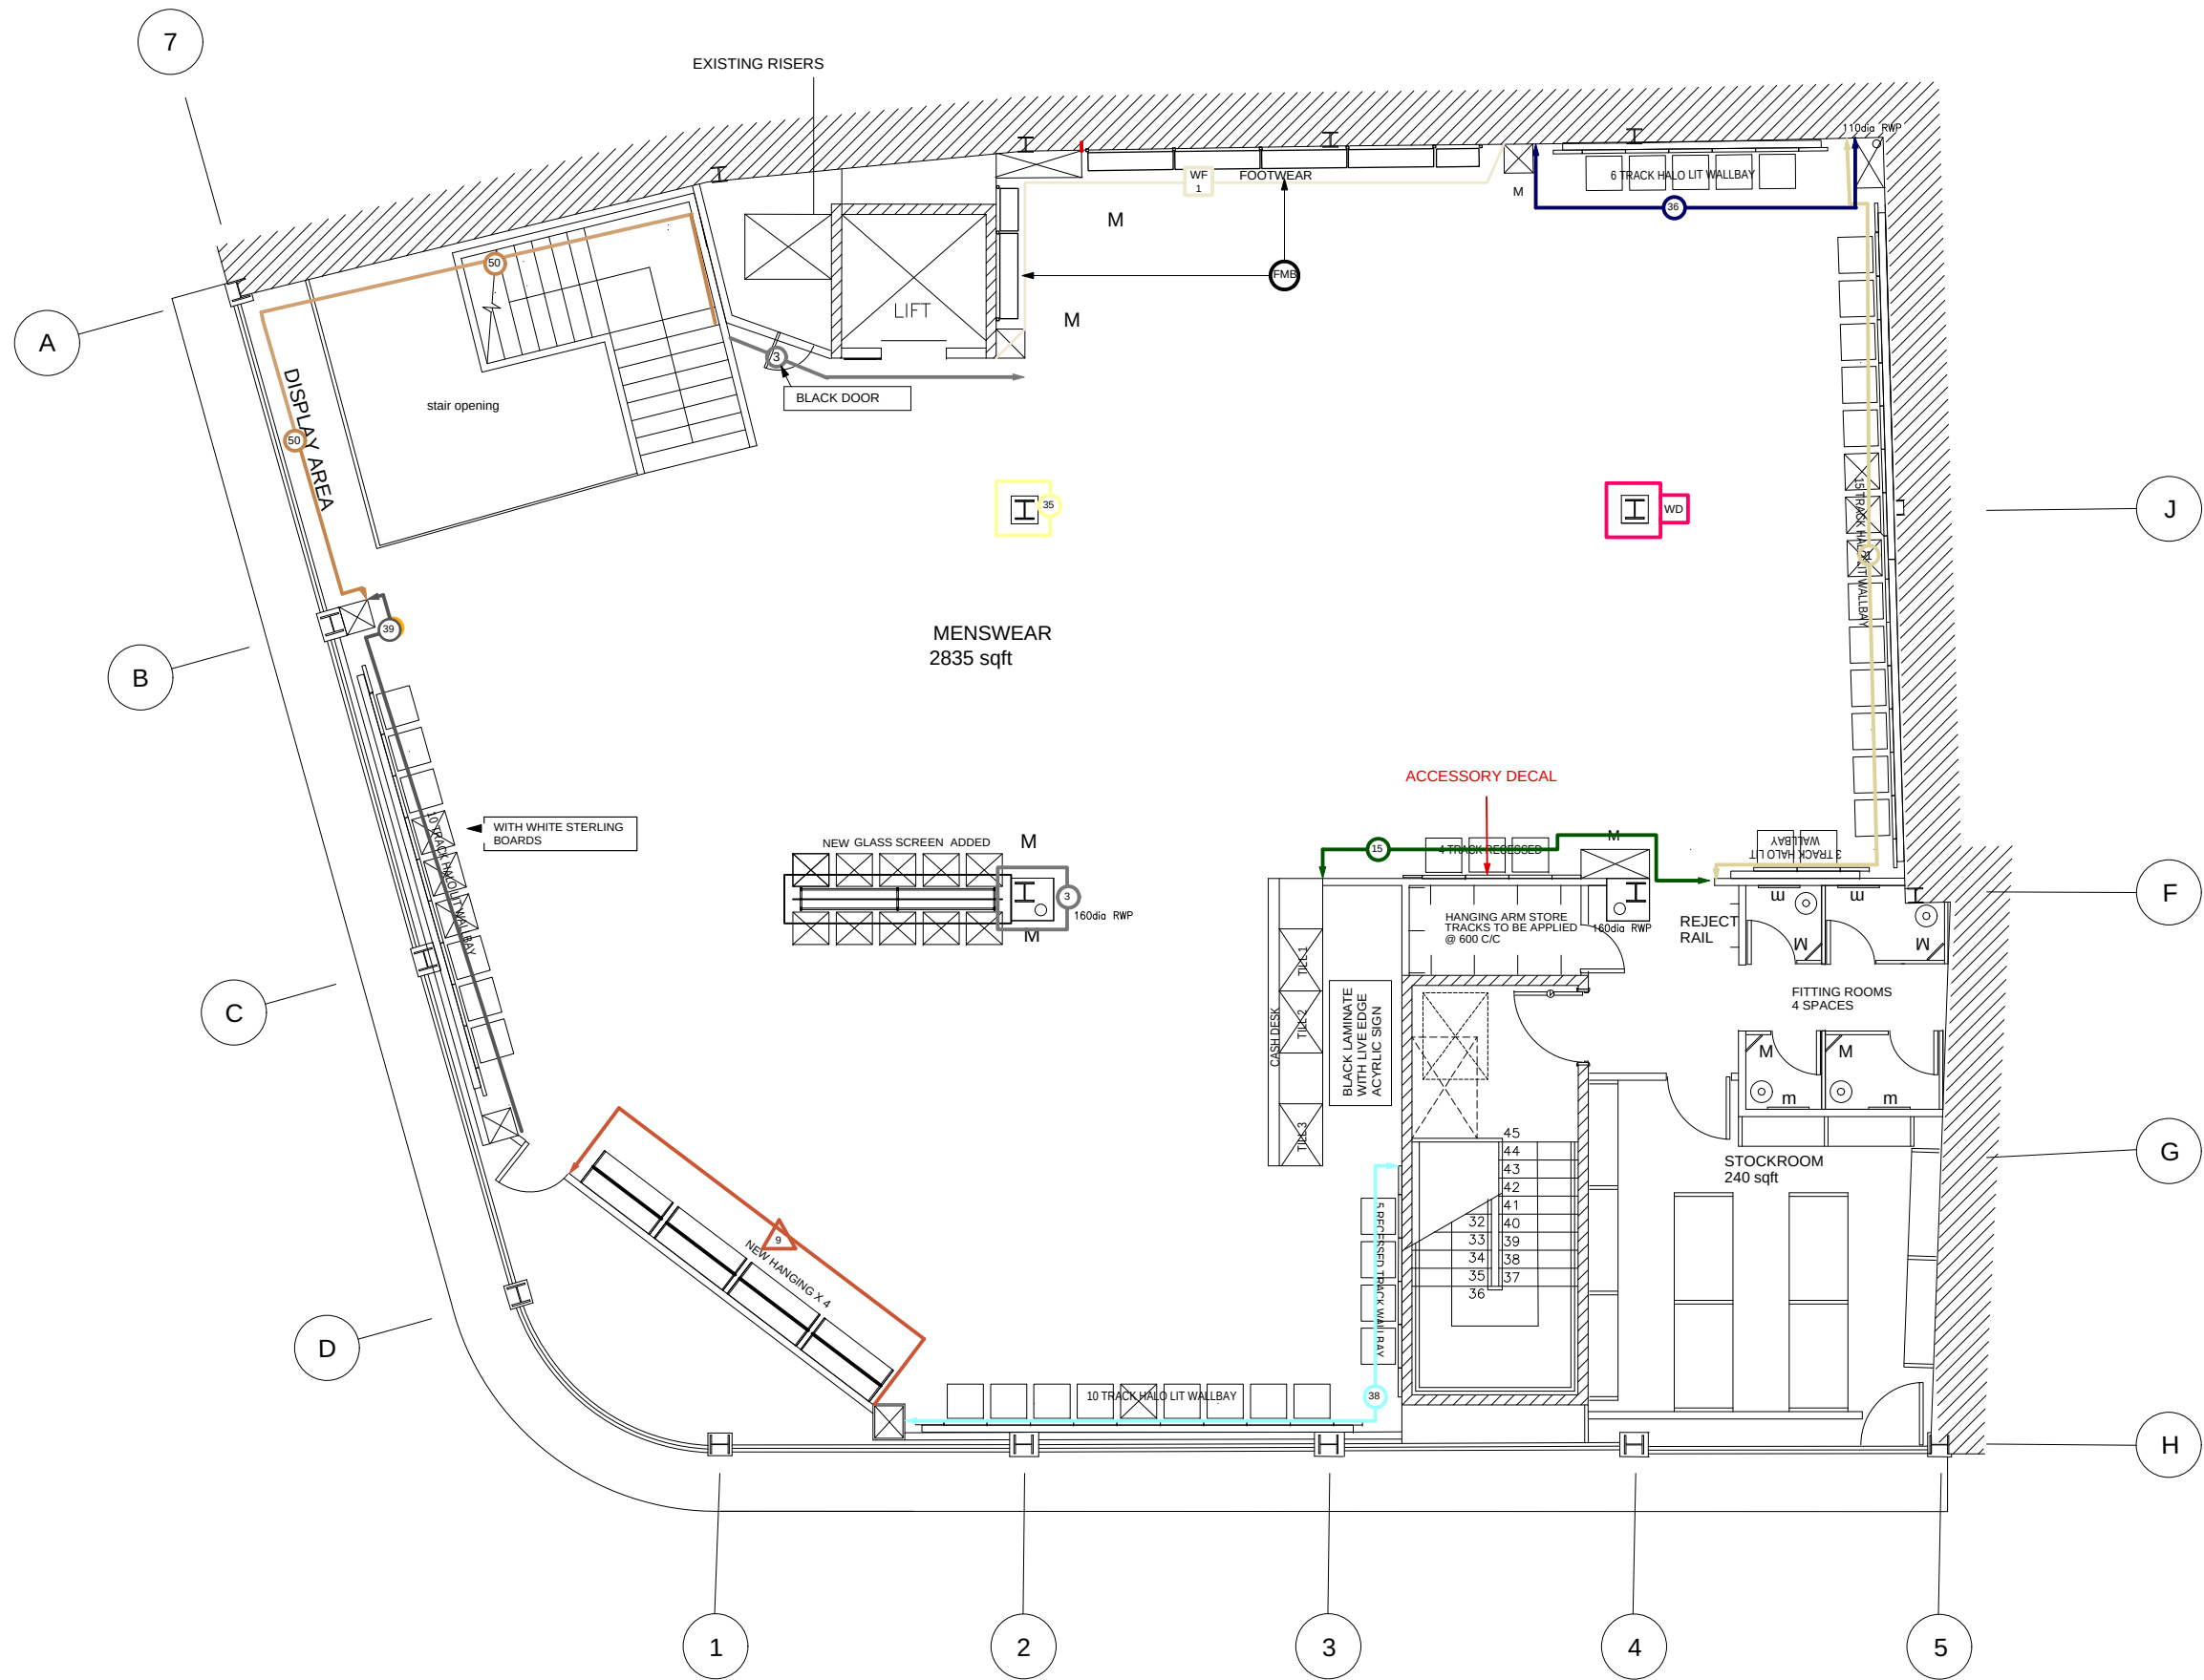